


FROGTOWN ROAD

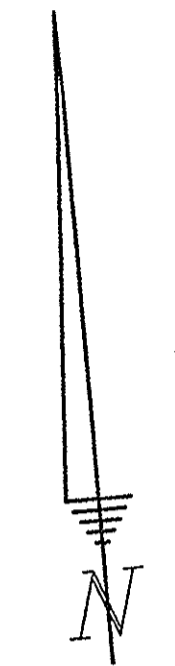

DROP BOX 7  
TOP = 927.61  
INV. = 923.81  
WINDOW = 926.55

DROP BOX 6  
RIM = 926.76  
INV. = 923.01  
WINDOW = 925.75

DROP BOX 4  
TOP = 935.79  
INV. = 931.22

DROP BOX 3  
TOP = 927.98  
INV. = 924.35  
WINDOW = 926.86

DROP BOX 2  
TOP = 926.81  
INV. = 923.01

DROP BOX 5  
TOP = 922.74  
INV. = 917.96

DROP BOX 6  
RIM = 921.72  
INV. = 918.12

DROP BOX 1  
RIM = 919.96  
INV. = 915.59

DROP BOX 5  
RIM = 920.14  
INV. = 916.44

DROP BOX 9  
RIM = 920.22  
INV. = 917.02

M.H. 8  
RIM = 917.16  
INV. = 908.92

M.H. 9  
RIM = 917.25  
INV. = 910.01

M.H. 7  
RIM = 914.88  
INV. = 908.00  
INV. = 907.68

M.H. 6  
RIM = 906.96  
INV. = 899.06

M.H. 10  
RIM = 915.95  
INV. = 899.25

DROP BOX 4  
RIM = 912.20  
INV. = 906.40

M.H. 6  
RIM = 919.45  
INV. = 910.30

M.H. 4  
RIM = 915.89  
INV. = 902.13

M.H. 3  
RIM = 914.35  
INV. = 900.54

M.H. 1  
TOP = 910.47  
INV. = 906.01

M.H. 10  
RIM = 915.95  
INV. = 899.25

STORM M.H. 18  
RIM = 909.93  
INV. = 902.63

M.H. 5  
RIM = 910.99  
INV. = 897.71

LOT 9

M.H. 4  
RIM = 905.79  
INV. = 897.00

STORM M.H. 16  
RIM = 905.90  
INV. = 895.10

M.H. 1  
RIM = 906.91  
INV. = 896.15


OVERFLOW STURTURE  
WINDOW = 905.93  
INV. = 897.88

STORM M.H. 17  
RIM = 906.76  
INV. = 896.46

STORM M.H. 13  
RIM = 905.94  
INV. = 895.11

STORM M.H. 15  
RIM = 905.51  
INV. = 894.24

STORM M.H. 14  
RIM = 903.75  
INV. = 892.95

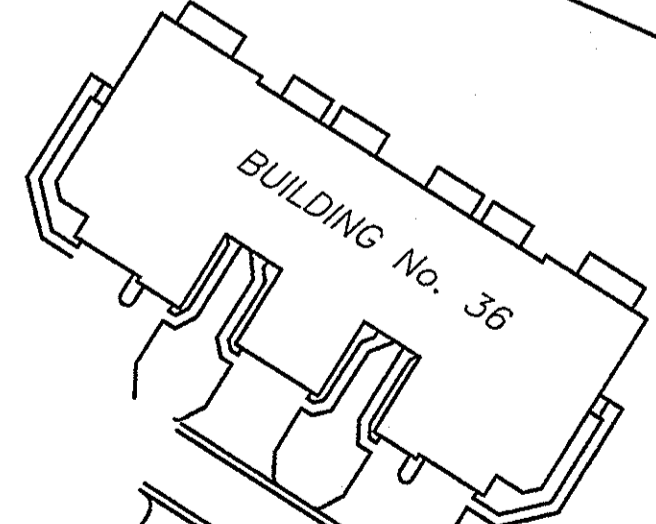

RECORD COPY OF DRAWINGS			
SECTION No. 24			
TRIPLE CROWN COUNTRY CLUB			
SCALE: 1" = 50'	APPROVED BY: JAMES W. BERLING KY. SURVEYOR 206	DATE: 11/7/12	DRAWN BY: Chris D. Berling
RICHWOOD, BOONE Co, KY			
DRAWING NUMBER			

HOLE No. 16